



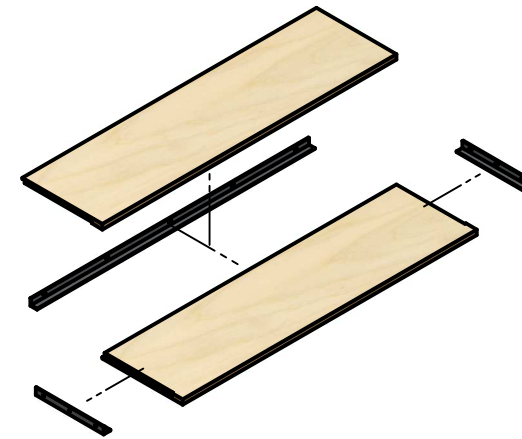


EXPLODED VIEW


ALL PARTS 18mm BIRCH
FACED PLY, SUPPORTED ON
25 x 25 x 3mm STEEL ANGLE.
MATT VARNISH FINISH

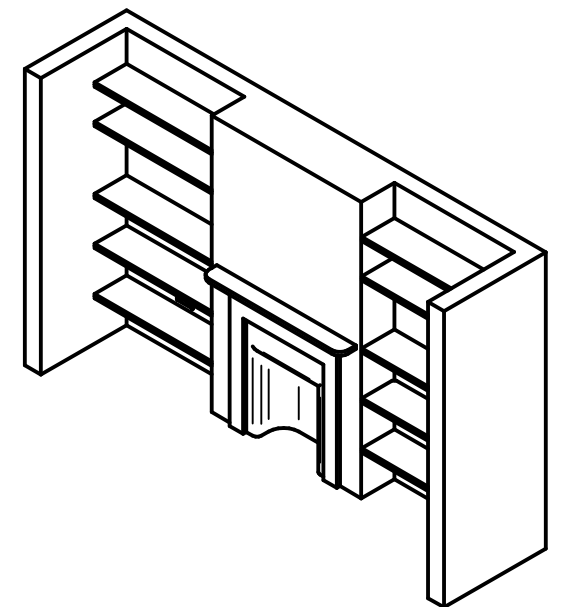

ISOMETRIC VIEW
SCALE 1:50

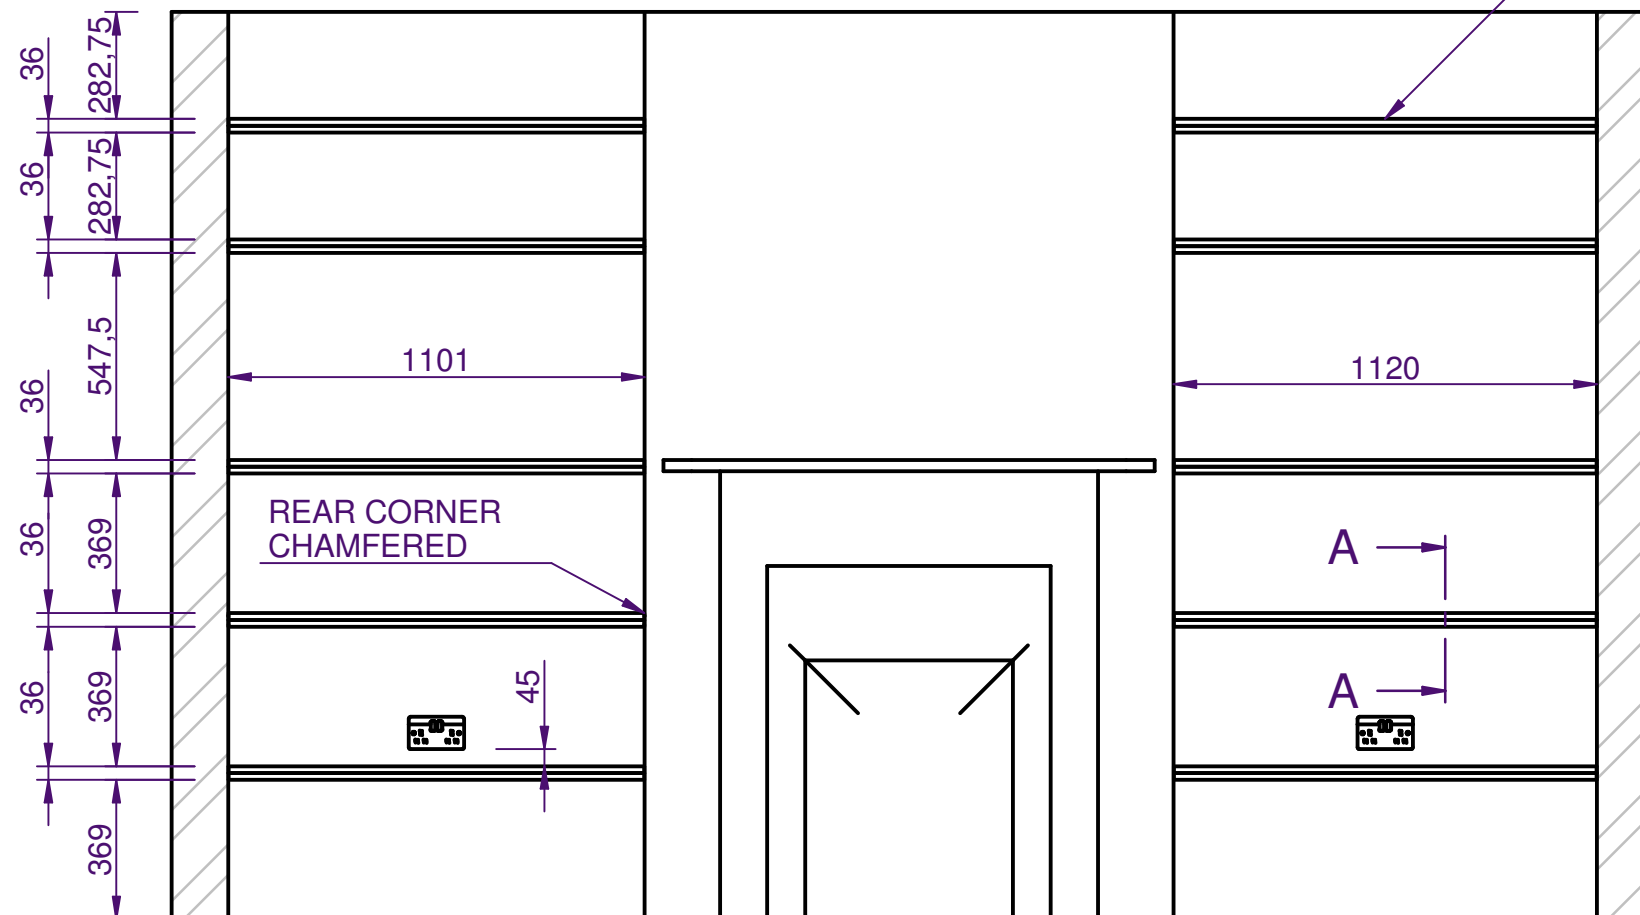

FRONT ELEVATION
SCALE 1:20

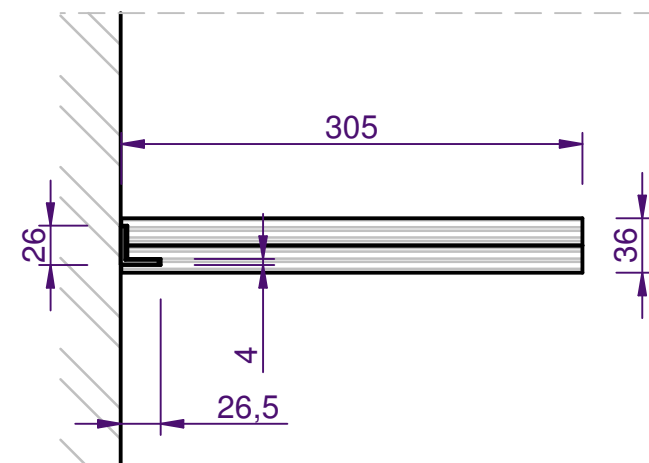

HEIGHT SECTION A-A
SCALE 1:5

REVISION HISTORY		
REV	DESCRIPTION	DATE
A	FIRST ISSUE	15/03/2017
A/B	AS BUILT ISSUE	21/07/2018

AS BUILT



C-A Design

26 TREDEGAR ROAD,
DARTFORD, KENT DA2 7AZ
WWW.C-ADESIGN.CO.UK
+44 (0)7415 839 461
INFO@C-ADESIGN.CO.UK

PROJECT:	CLIENT DETAILS
TITLE:	J02 LOUNGE SHELVES
DETAILS:	RENDERED VISUAL ISOMETRIC, ELEVATION & SECTION
DATE:	15/03/2017
SHEET:	1 OF 1
DRAWN:	A.CAVE-AYLAND
CHECK:	N/A
SCALE:	AS SHOWN @ A3

DRAWING N°:	REVISION:
DRG 0001 J02 - 1	A/B