




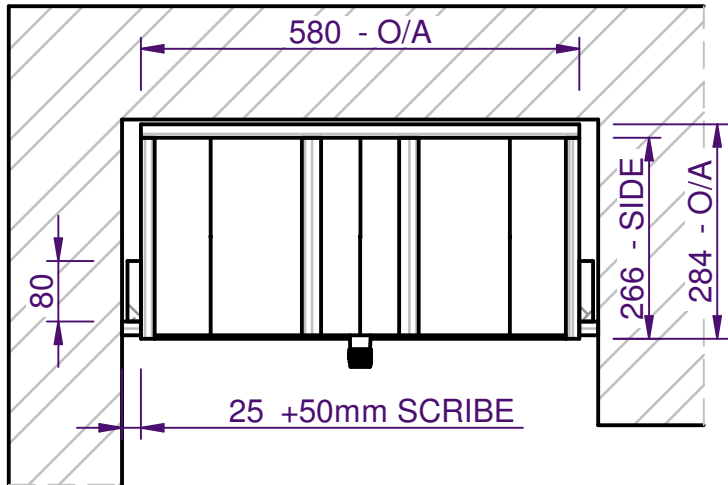


PLAN SECTION A-A
SCALE 1:10

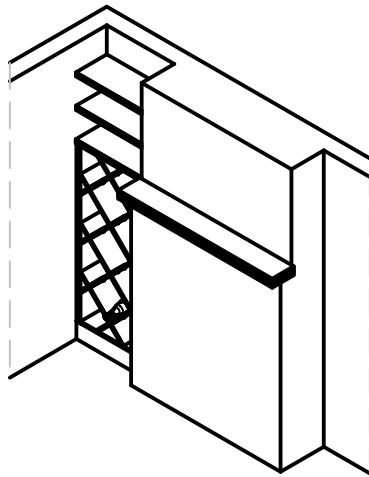

ISOMETRIC VIEW
SCALE 1:50

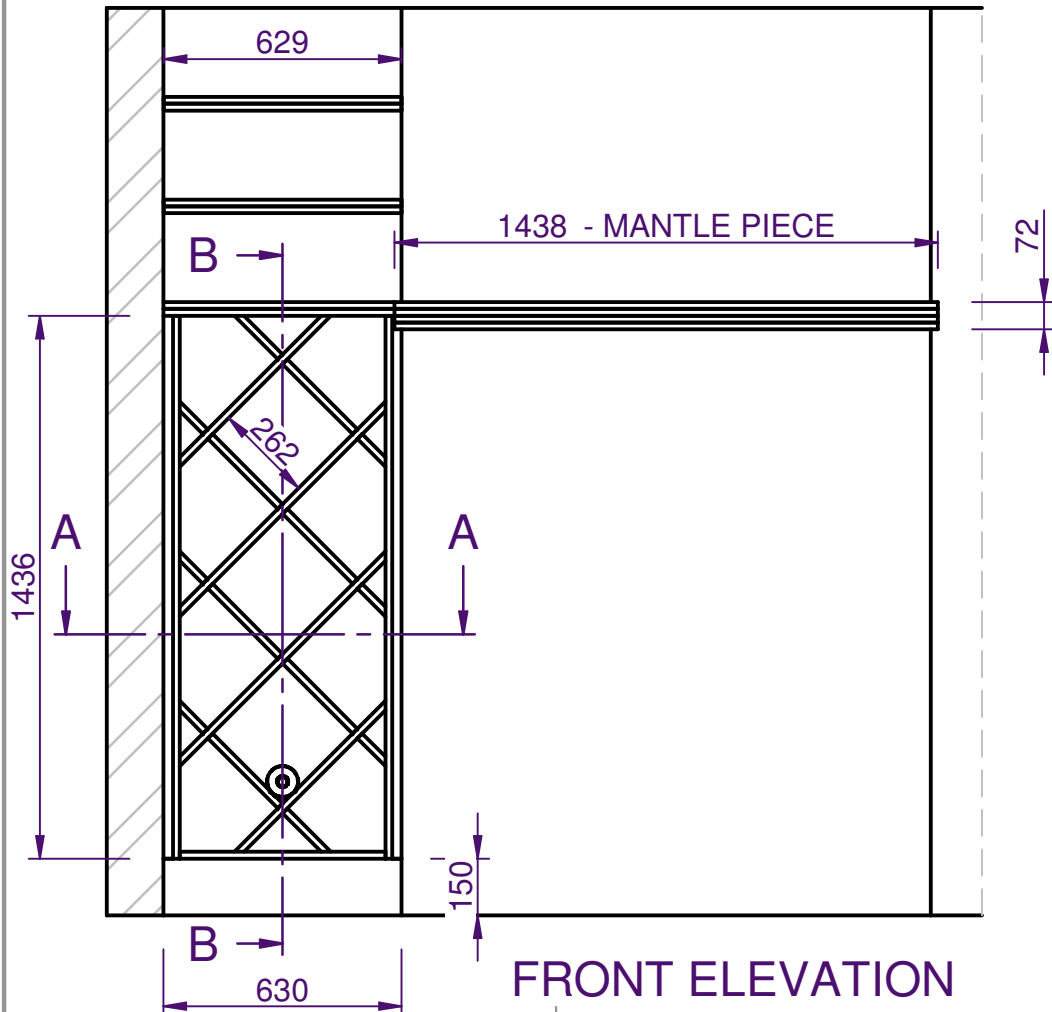

FRONT ELEVATION
SCALE 1:20

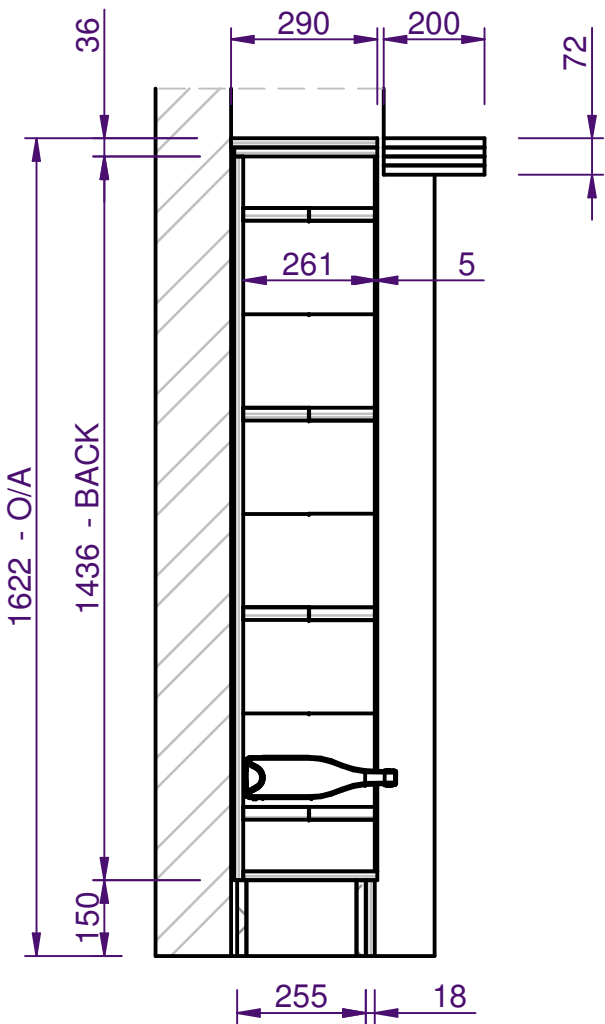

HEIGHT SECTION B-B
SCALE 1:15

REVISION HISTORY		
REV	DESCRIPTION	DATE
A	FIRST ISSUE	21/03/2017
B	DESIGN UPDATED	04/04/2017
A/B	AS BUILT ISSUE	21/07/2018

AS BUILT



C-A Design

26 TREDEGAR ROAD,
DARTFORD, KENT DA2 7AZ
WWW.C-ADESIGN.CO.UK
+44 (0)7415 839 461
INFO@C-ADESIGN.CO.UK

PROJECT:	CLIENT DETAILS
TITLE:	J03 WINE RACK
DETAILS:	VISUALISATION ISO, ELEVATION, SECTIONS
DATE:	21/03/2017
SHEET:	1 OF 2
DRAWN:	A. CAVE-AYLAND
CHECK:	N/A
SCALE:	AS SHOWN @ A3

DRAWING N°:	REVISION:
DRG 0001 J03 - 1	A/B

