





REVISION HISTORY		
REV	DESCRIPTION	DATE
A	FIRST ISSUE	25/03/2017
A/B	AS BUILT ISSUE	21/07/2018

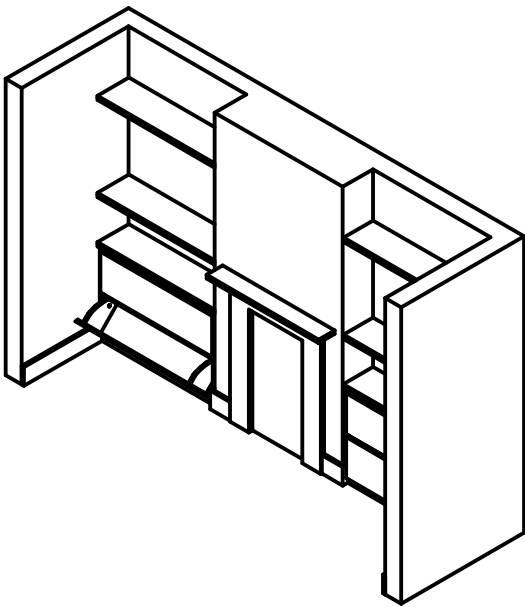

ISOMETRIC VIEW
SCALE 1:50

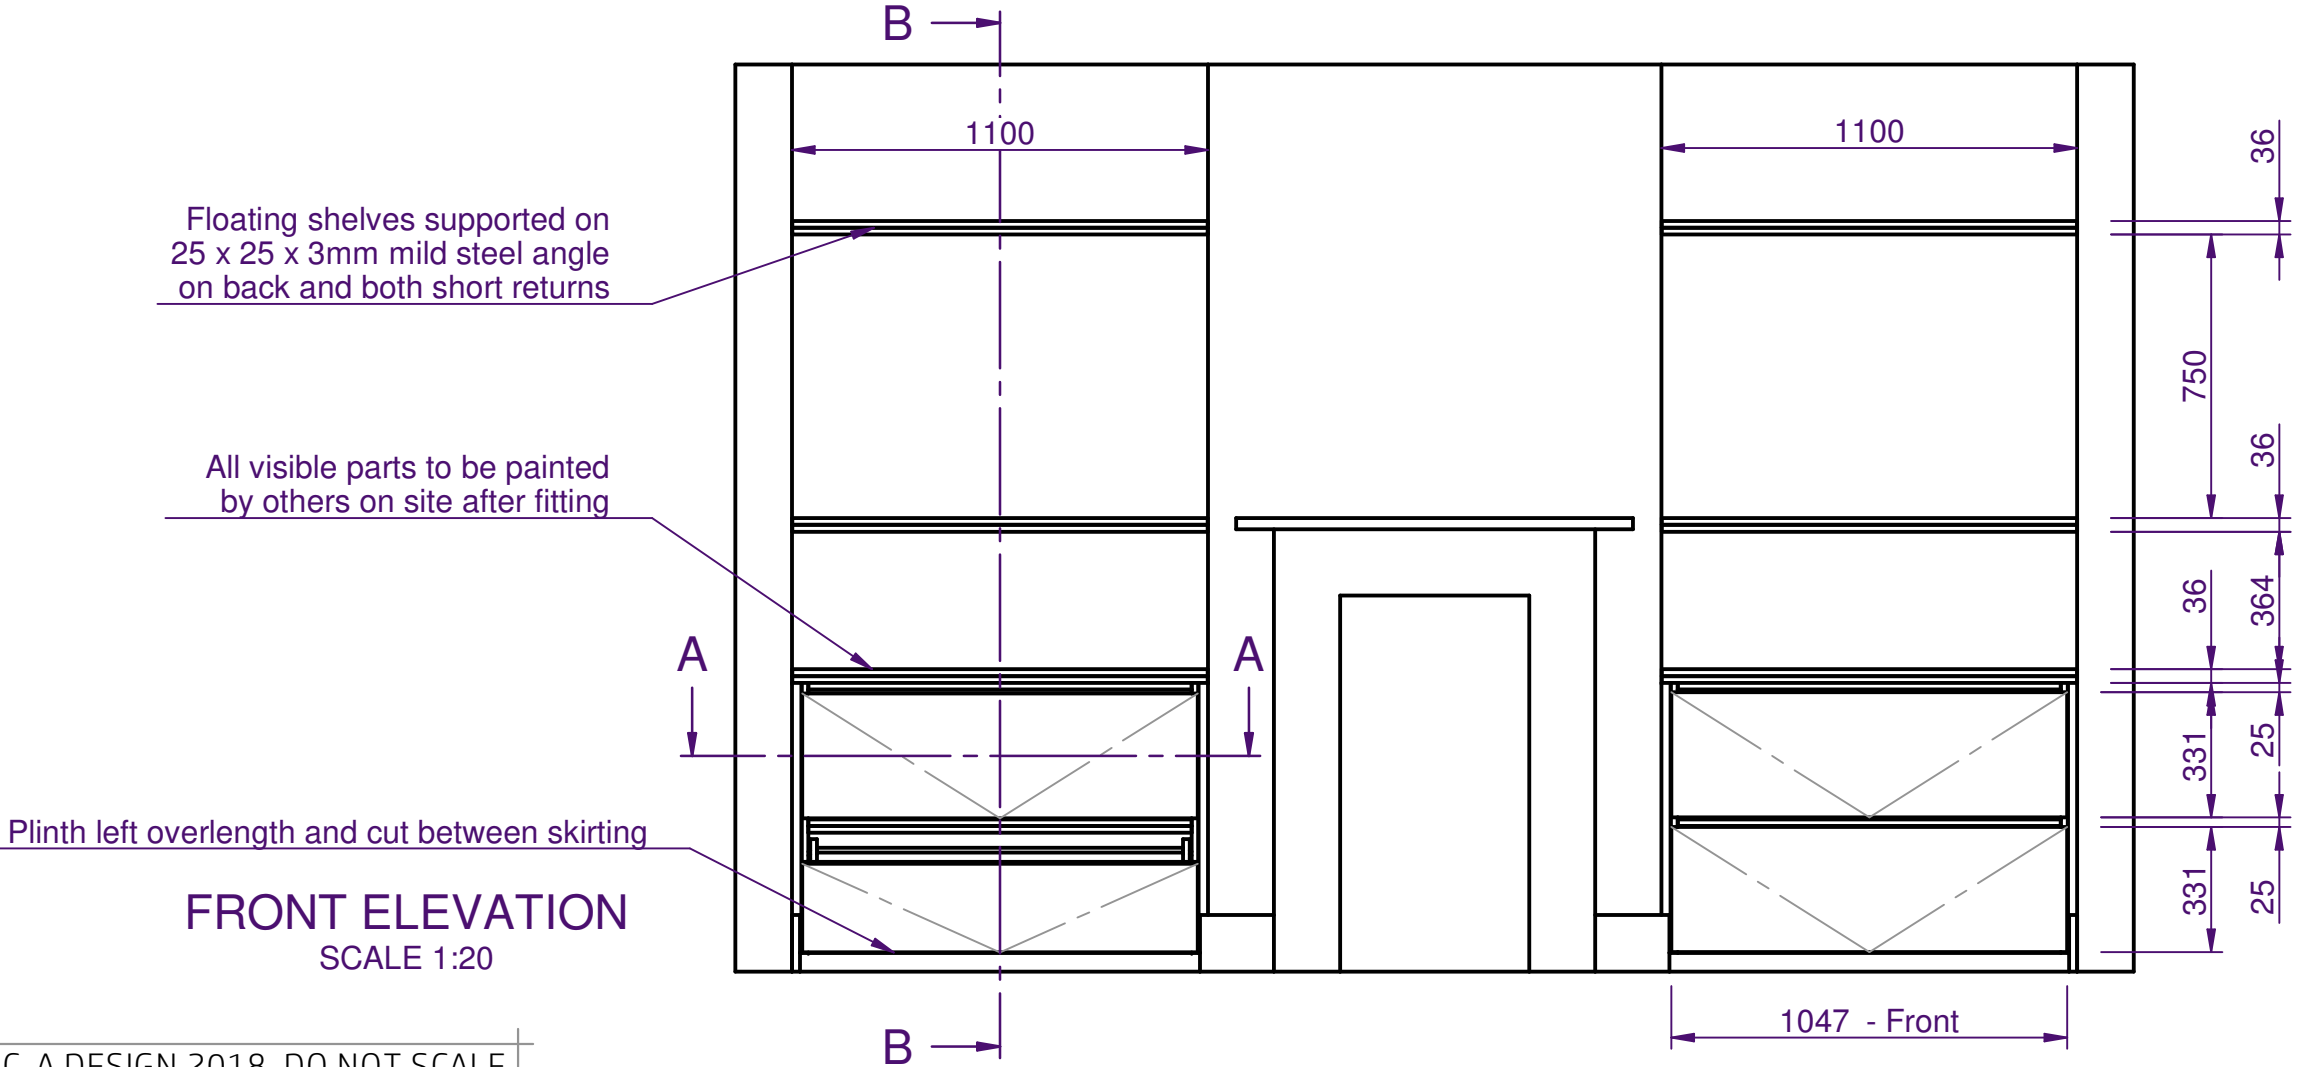


AS BUILT




C-A Design
26 TREDEGAR ROAD,
DARTFORD, KENT DA2 7AZ
WWW.C-ADESIGN.CO.UK
+44 (0)7415 839 461
INFO@C-ADESIGN.CO.UK

PROJECT:	CLIENT DETAILS
TITLE:	J03 BEDROOM STORAGE
DETAILS:	VISUALISATION ISOMETRIC & FRONT VIEWS
DATE:	25/03/2017
SHEET:	1 OF 2
DRAWN:	A. CAVE-AYLAND
CHECK:	N/A
SCALE:	AS SHOWN @ A3
DRAWING N°:	DRG 0001 J03 - 1
REVISION:	A/B

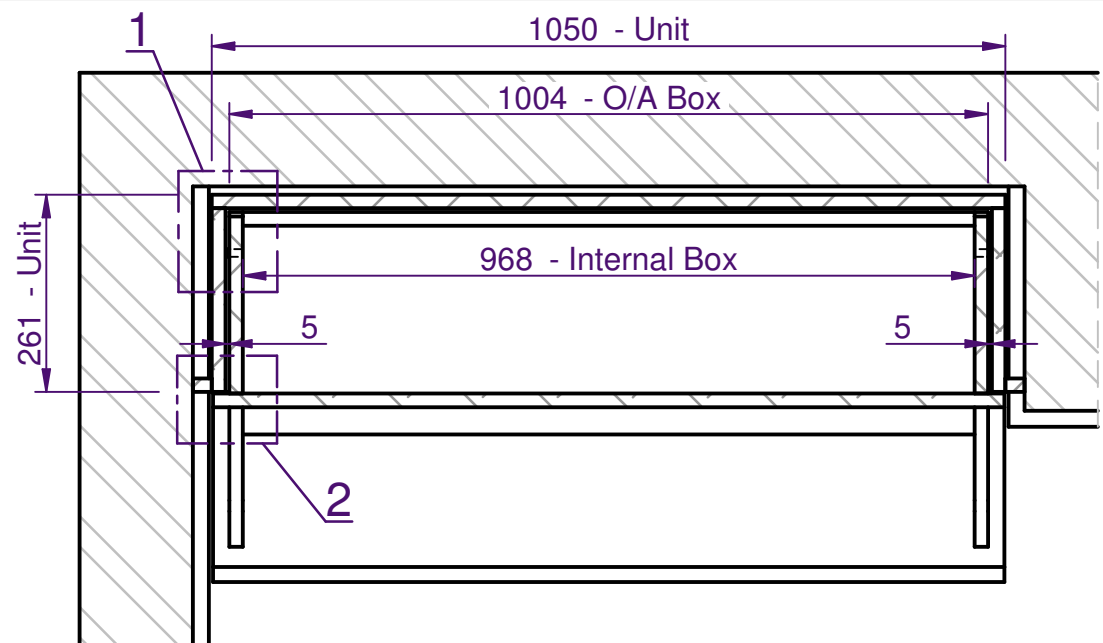


PLAN SECTION A-A
SCALE 1:10

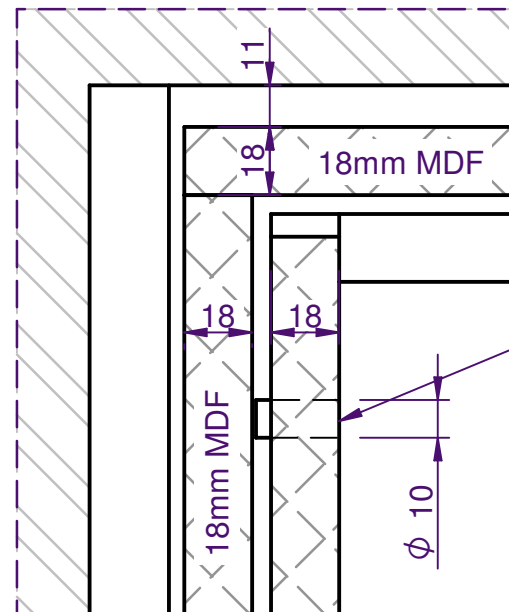


DETAIL 1
SCALE 1:2

Box to be fitted and hinges adjusted, then Ø10mm dowel hammered through to catch on retainer and trimmed flush

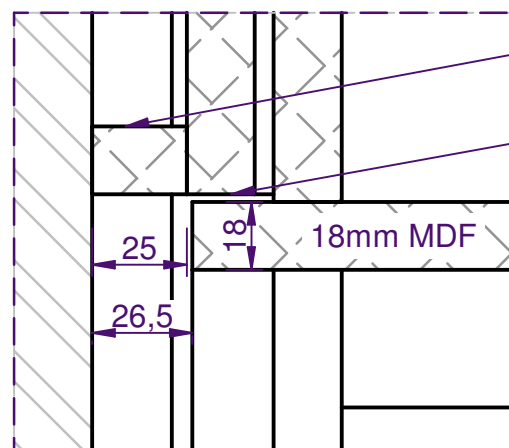


DETAIL 2
SCALE 1:2

Allow 50mm site scribe
Gap to allow for silicone buffer

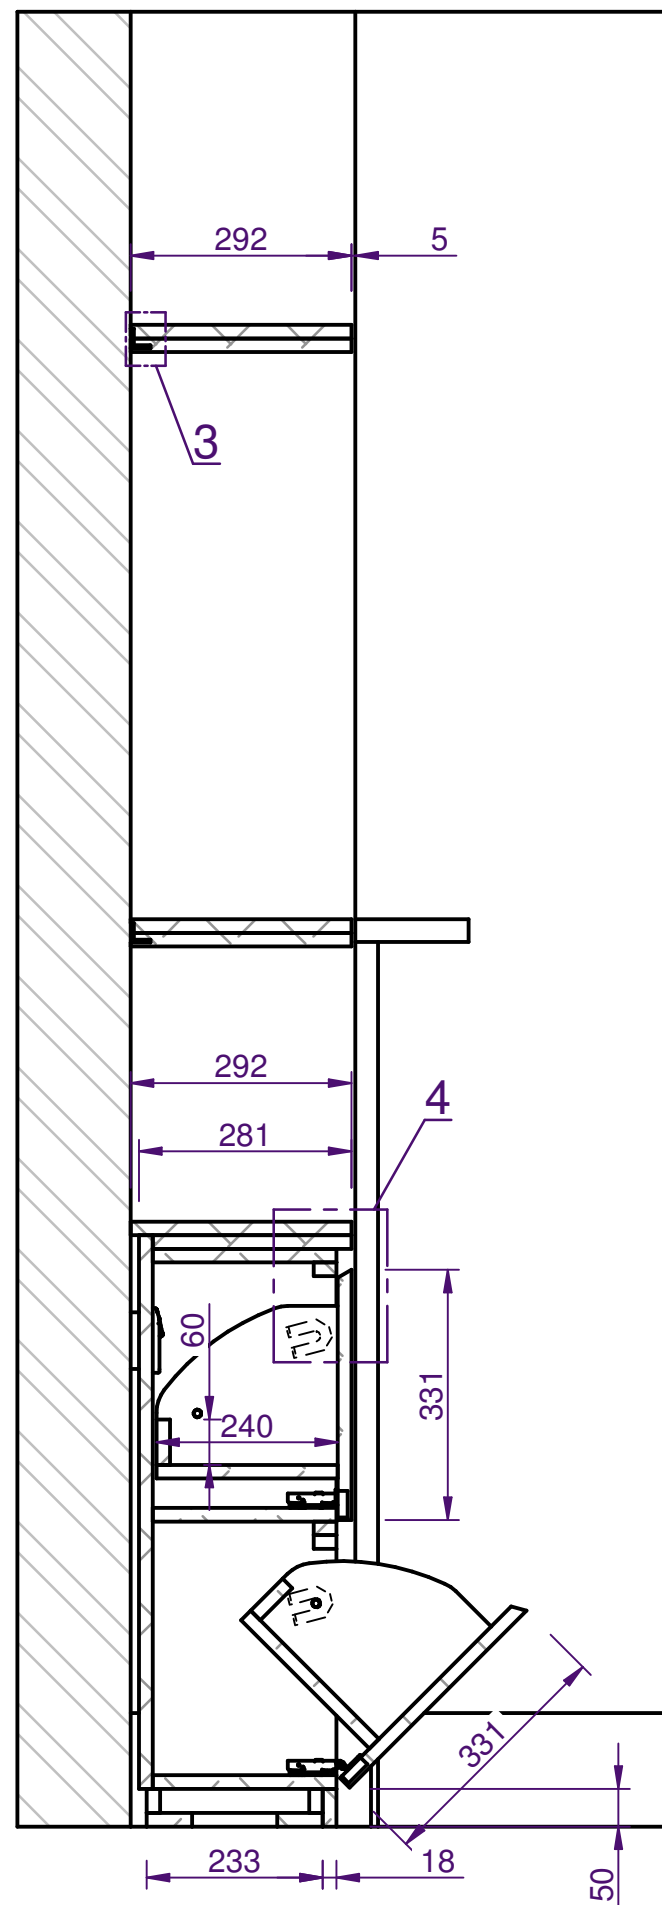

HEIGHT SECTION B-B
SCALE 1:10


REVISION HISTORY		
REV	DESCRIPTION	DATE
A	FIRST ISSUE	25/03/2017
A/B	AS BUILT ISSUE	21/07/2018

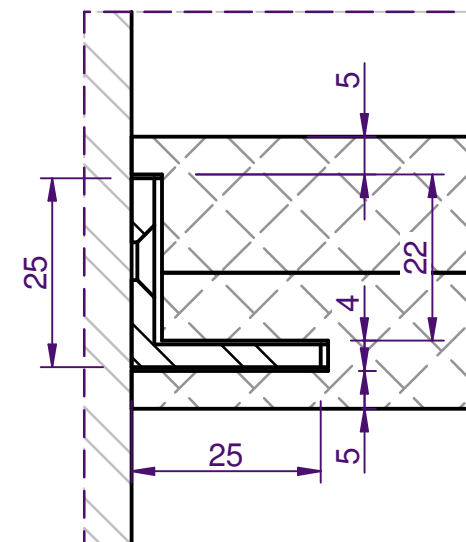

DETAIL 3
SCALE 1:1

Dowel arrestor

DETAIL 4
SCALE 1:2

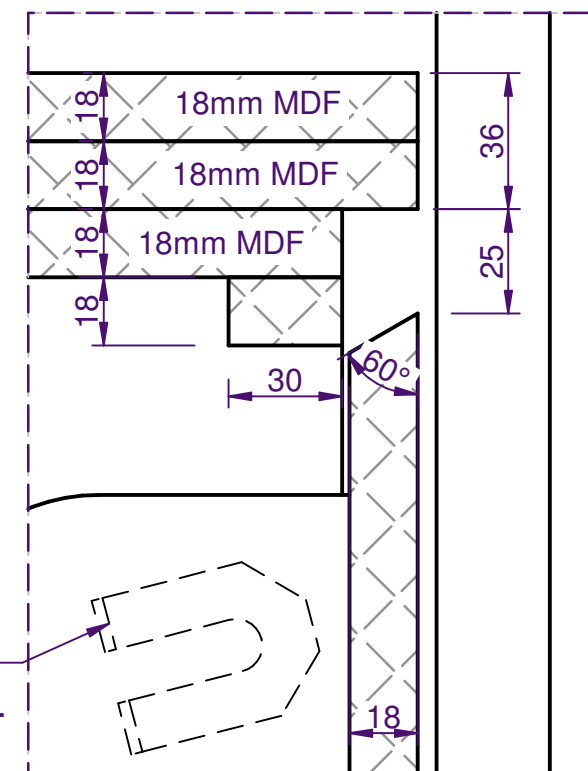

AS BUILT



C-A Design

26 TREDEGAR ROAD,
DARTFORD, KENT DA2 7AZ
WWW.C-ADESIGN.CO.UK
+44 (0)7415 839 461
INFO@C-ADESIGN.CO.UK

PROJECT:	CLIENT DETAILS
TITLE:	J03 BEDROOM STORAGE
DETAILS:	PLAN SECTION A-A HEIGHT SECTION B-B
DATE:	25/03/2017
SHEET:	2 OF 2
DRAWN:	A. CAVE-AYLAND
CHECK:	N/A
SCALE:	AS SHOWN @ A3

DRAWING N°:	REVISION:
DRG 0001 J03 - 2	A/B