





REVISION HISTORY		
REV	DESCRIPTION	DATE
A	FIRST ISSUE	03/03/2017
A/B	AS BUILT ISSUE	21/07/2018

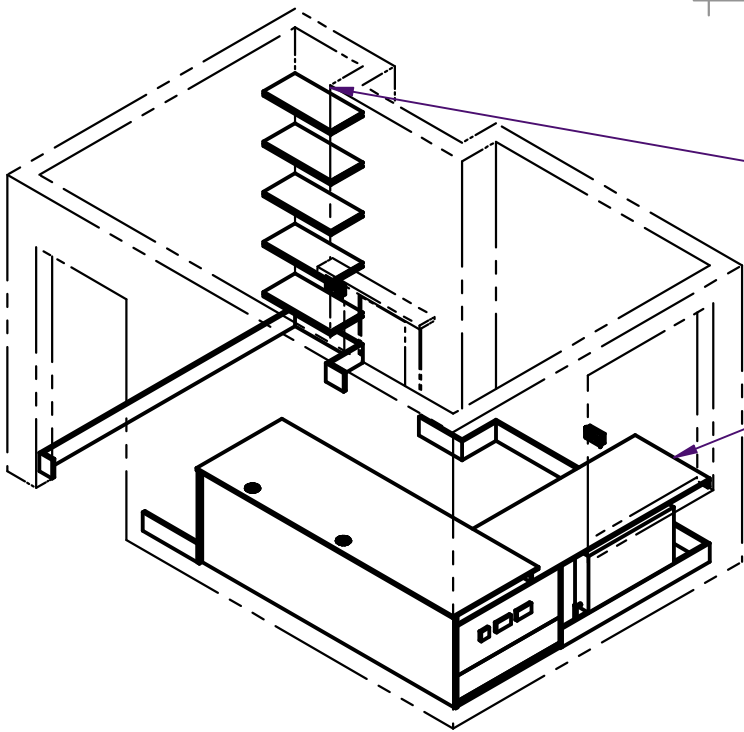

Shelves to be 2 N° layers of 18mm MR MDF, bonded together. Supported on 25 x 25 x 3mm mild steel angle. White gloss paint applied after fitting

All desk components 18mm MR MDF. White gloss paint applied after fitting. Drawer runners to be 2 N° pairs Hafele 422.41.955. 2 N° St.St effect cable grommets supplied by client

ISOMETRIC VIEW
SCALE 1:50

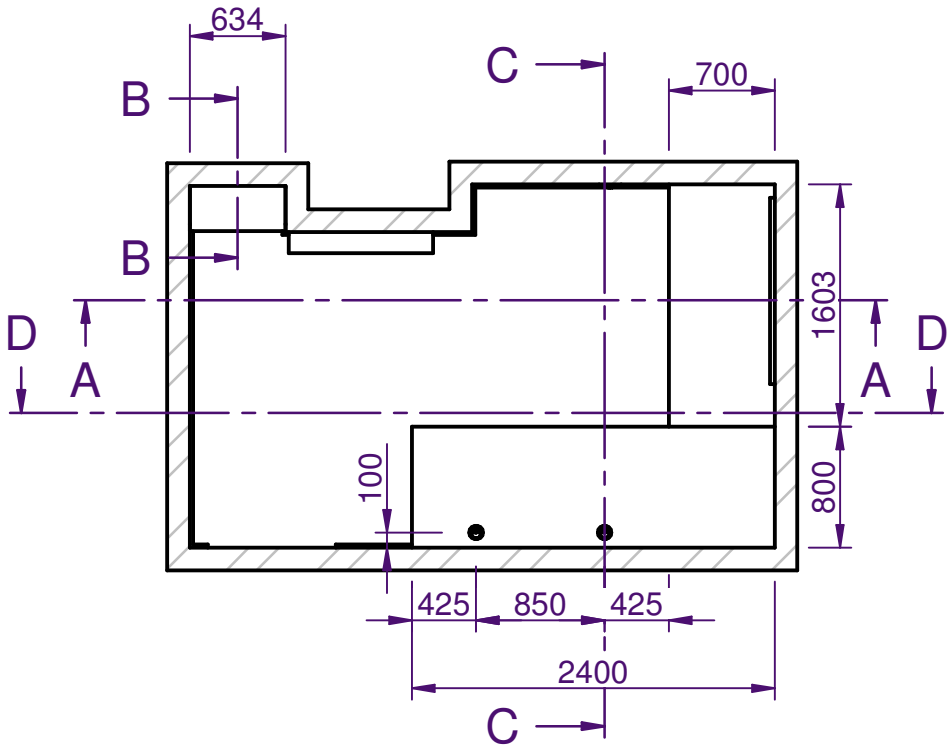


PLAN VIEW
SCALE 1:50

AS BUILT




C-A Design
26 TREDEGAR ROAD,
DARTFORD, KENT DA2 7AZ
WWW.C-ADESIGN.CO.UK
+44 (0)7415 839 461
INFO@C-ADESIGN.CO.UK


PROJECT:	CLIENT DETAILS
TITLE:	J04 OFFICE
DETAILS:	VISUALISATIONS ISOMETRIC & PLAN VIEWS
DATE:	03/03/2017
SHEET:	1 OF 3
DRAWN:	A. CAVE-AYLAND
CHECK:	N/A
SCALE:	AS SHOWN @ A3
DRAWING N°:	DRG 0001 J04 - 1
REVISION:	A/B

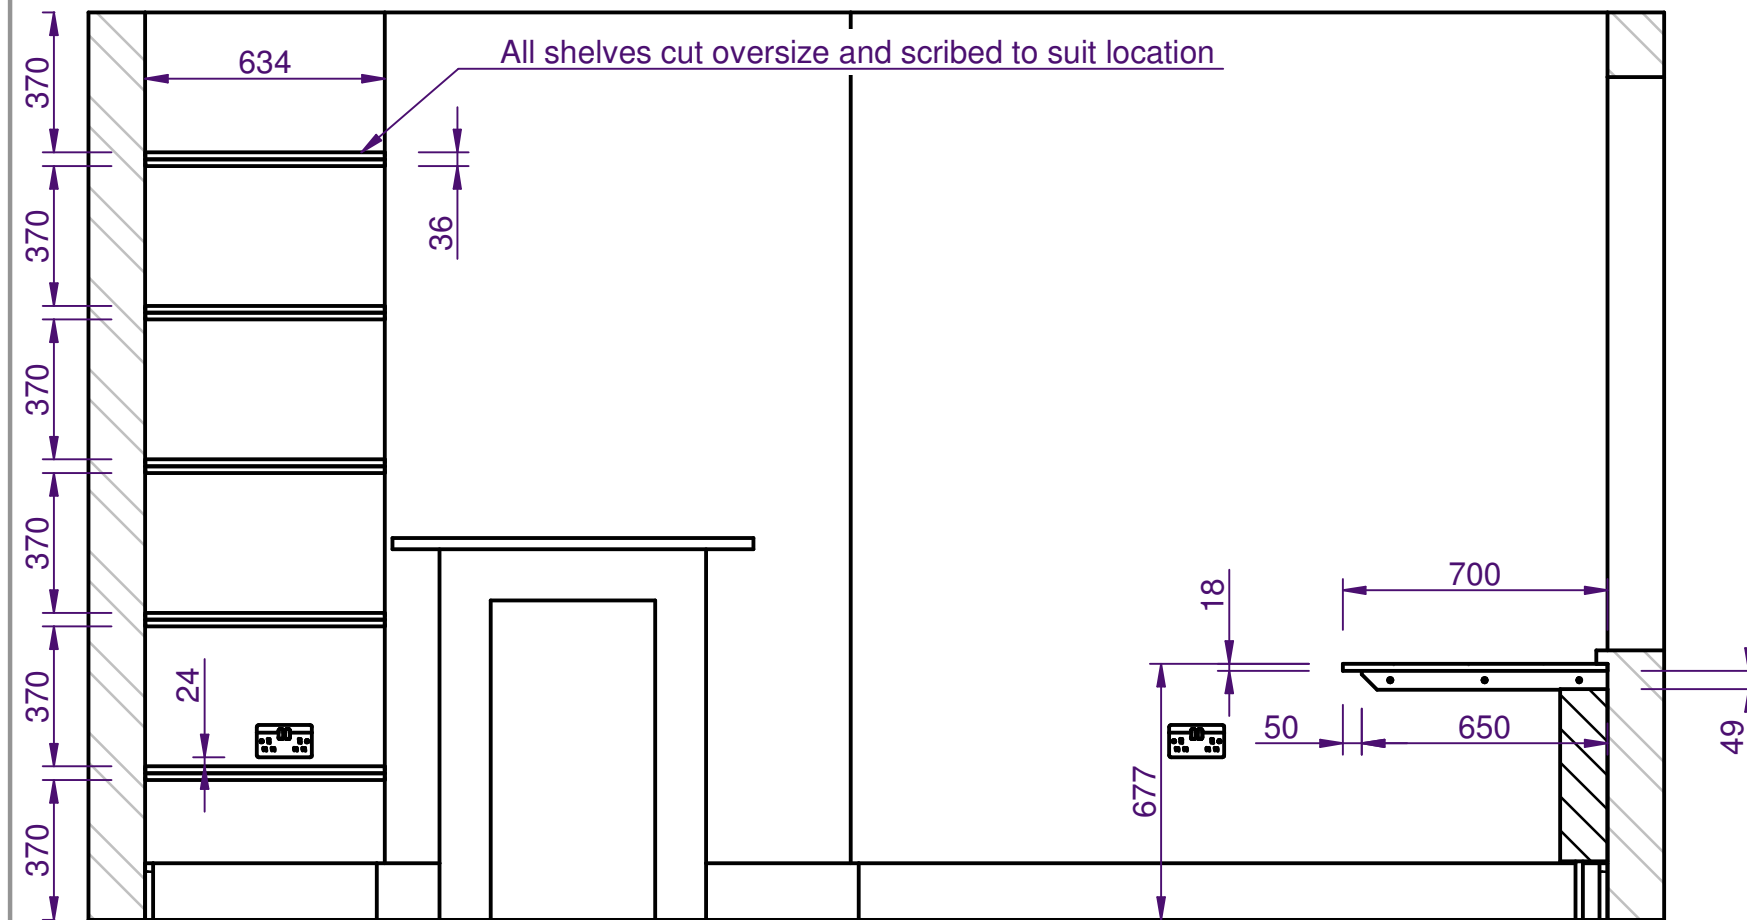


HEIGHT SECTION A-A
SCALE 1:20

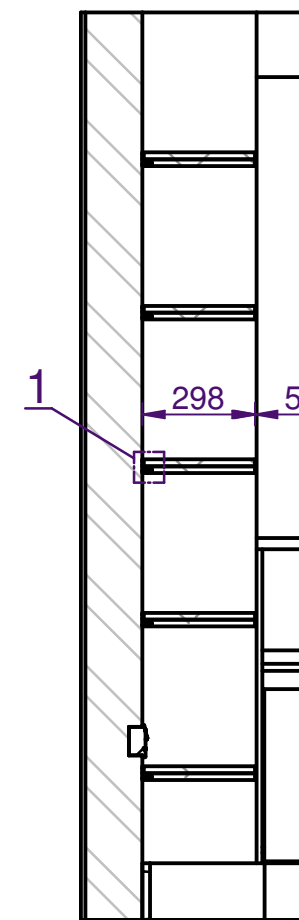

HEIGHT SECTION B-B
SCALE 1:20

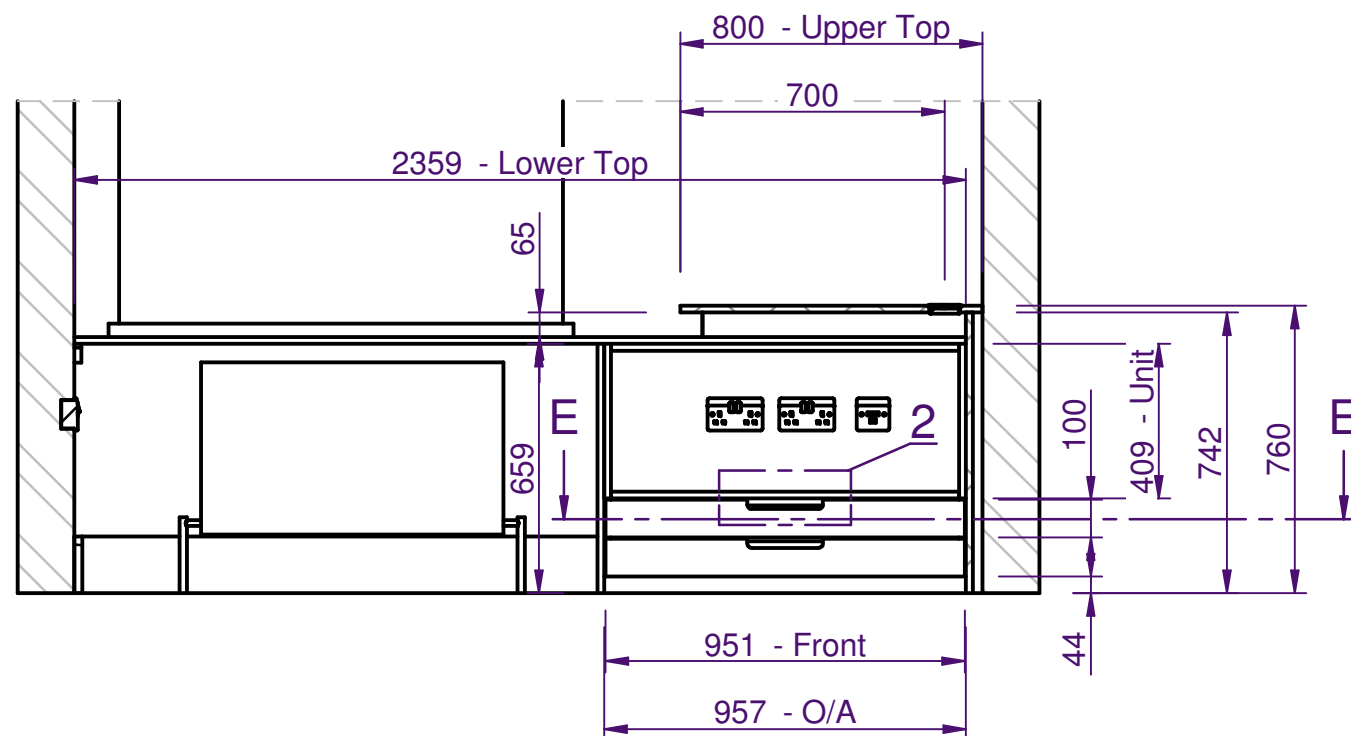


HEIGHT SECTION C-C
SCALE 1:20

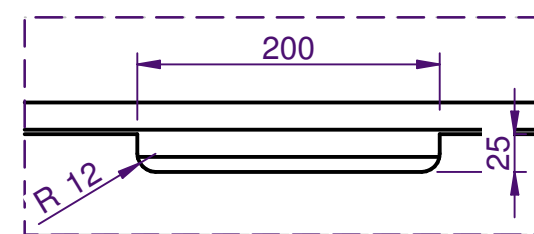

DETAIL 2
SCALE 1:5

REVISION HISTORY		
REV	DESCRIPTION	DATE
A	FIRST ISSUE	03/03/2017
A/B	AS BUILT ISSUE	21/07/2018

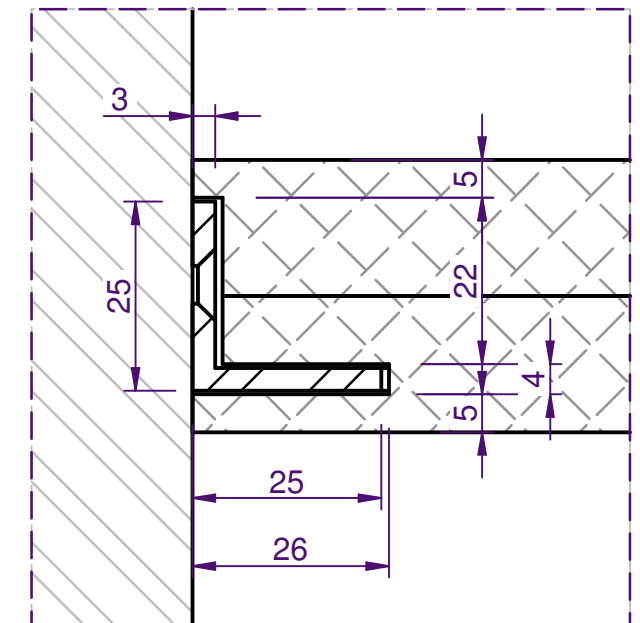

DETAIL 1
SCALE 1:1

AS BUILT




C-A Design


26 TREDEGAR ROAD,
DARTFORD, KENT DA2 7AZ
WWW.C-ADESIGN.CO.UK
+44 (0)7415 839 461
INFO@C-ADESIGN.CO.UK

PROJECT:	CLIENT DETAILS
TITLE:	J04 OFFICE
DETAILS:	HEIGHT SECTIONS A-A, B-B, C-C DETAILS 1 & 2
DATE:	03/03/2017
SHEET:	2 OF 3
DRAWN:	A. CAVE-AYLAND
CHECK:	N/A
SCALE:	AS SHOWN @ A3

DRAWING N°:	REVISION:
DRG 0001 J04 - 2	A/B

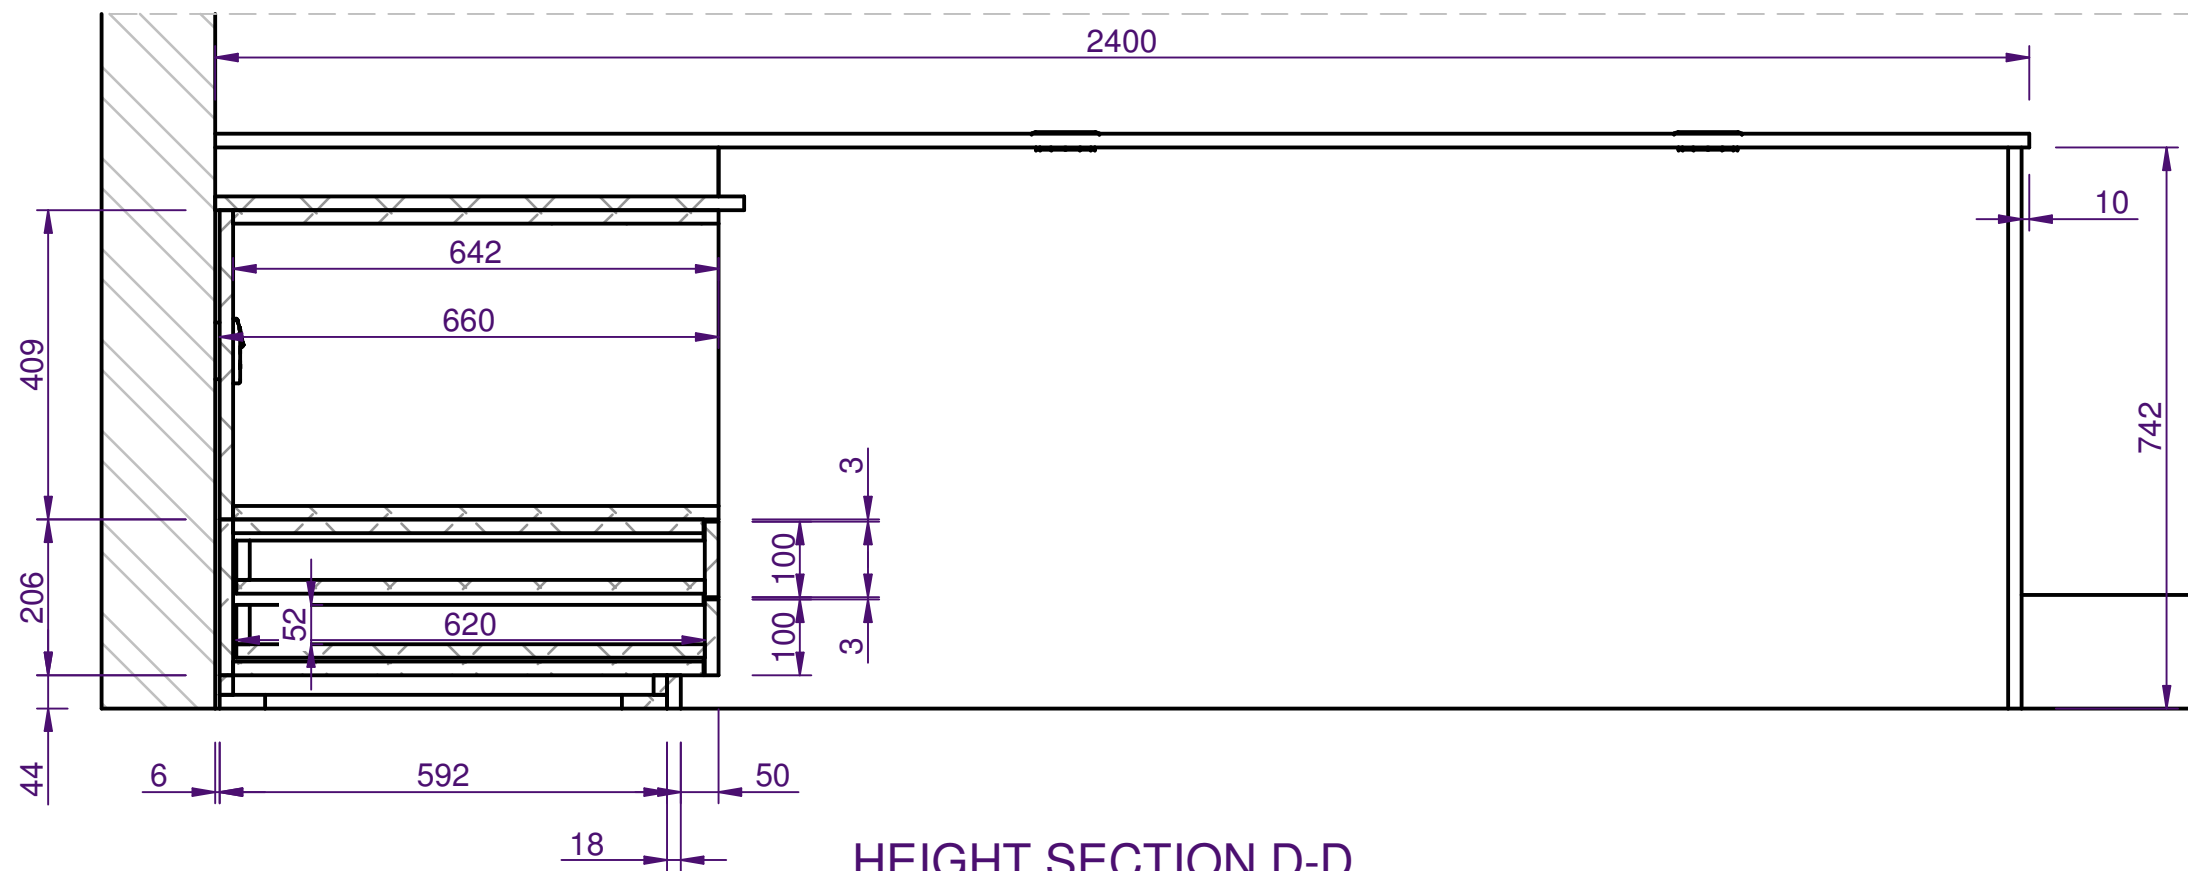

HEIGHT SECTION D-D
SCALE 1:10

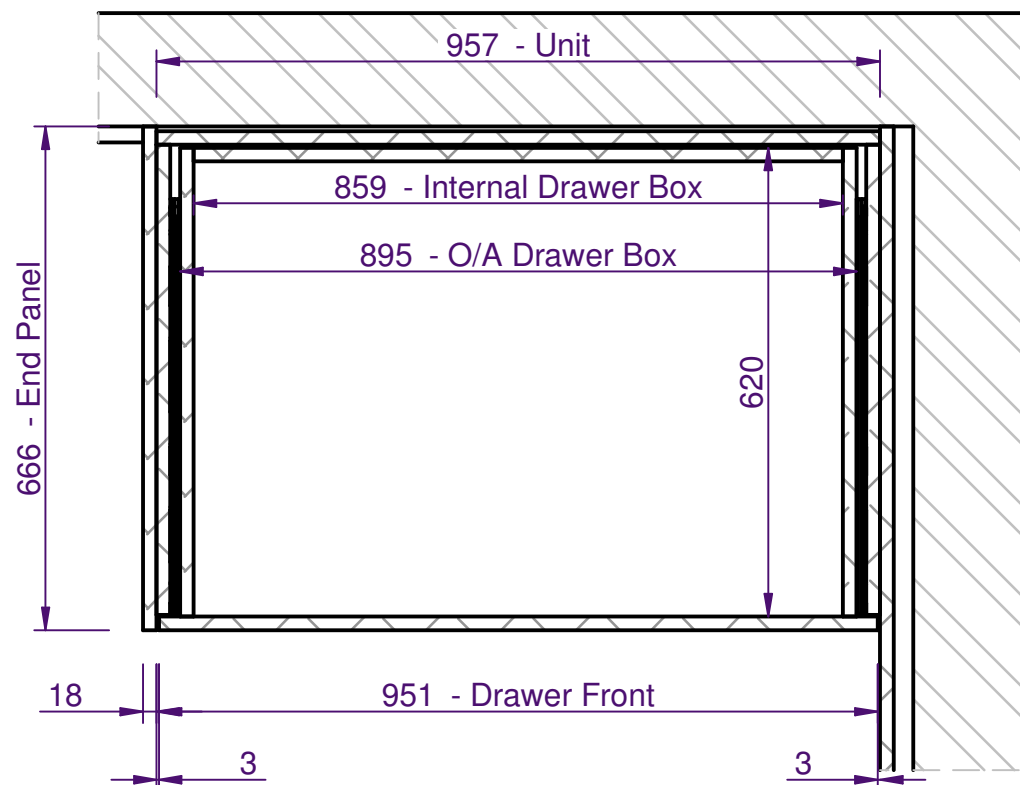

PLAN SECTION E-E
SCALE 1:10

REVISION HISTORY		
REV	DESCRIPTION	DATE
A	FIRST ISSUE	03/03/2017
A/B	AS BUILT ISSUE	21/07/2018

AS BUILT



C-A Design

26 TREDEGAR ROAD,
DARTFORD, KENT DA2 7AZ
WWW.C-ADESIGN.CO.UK
+44 (0)7415 839 461
INFO@C-ADESIGN.CO.UK

PROJECT:	CLIENT DETAILS
TITLE:	J04 OFFICE
DETAILS:	HEIGHT SECTION D-D PLAN SECTION E-E
DATE:	03/03/2017
SHEET:	3 OF 3
DRAWN:	A. CAVE-AYLAND
CHECK:	N/A
SCALE:	AS SHOWN @ A3

DRAWING N°:	REVISION:
DRG 0001 J04 - 3	A/B